


AS-BUILT PLAN

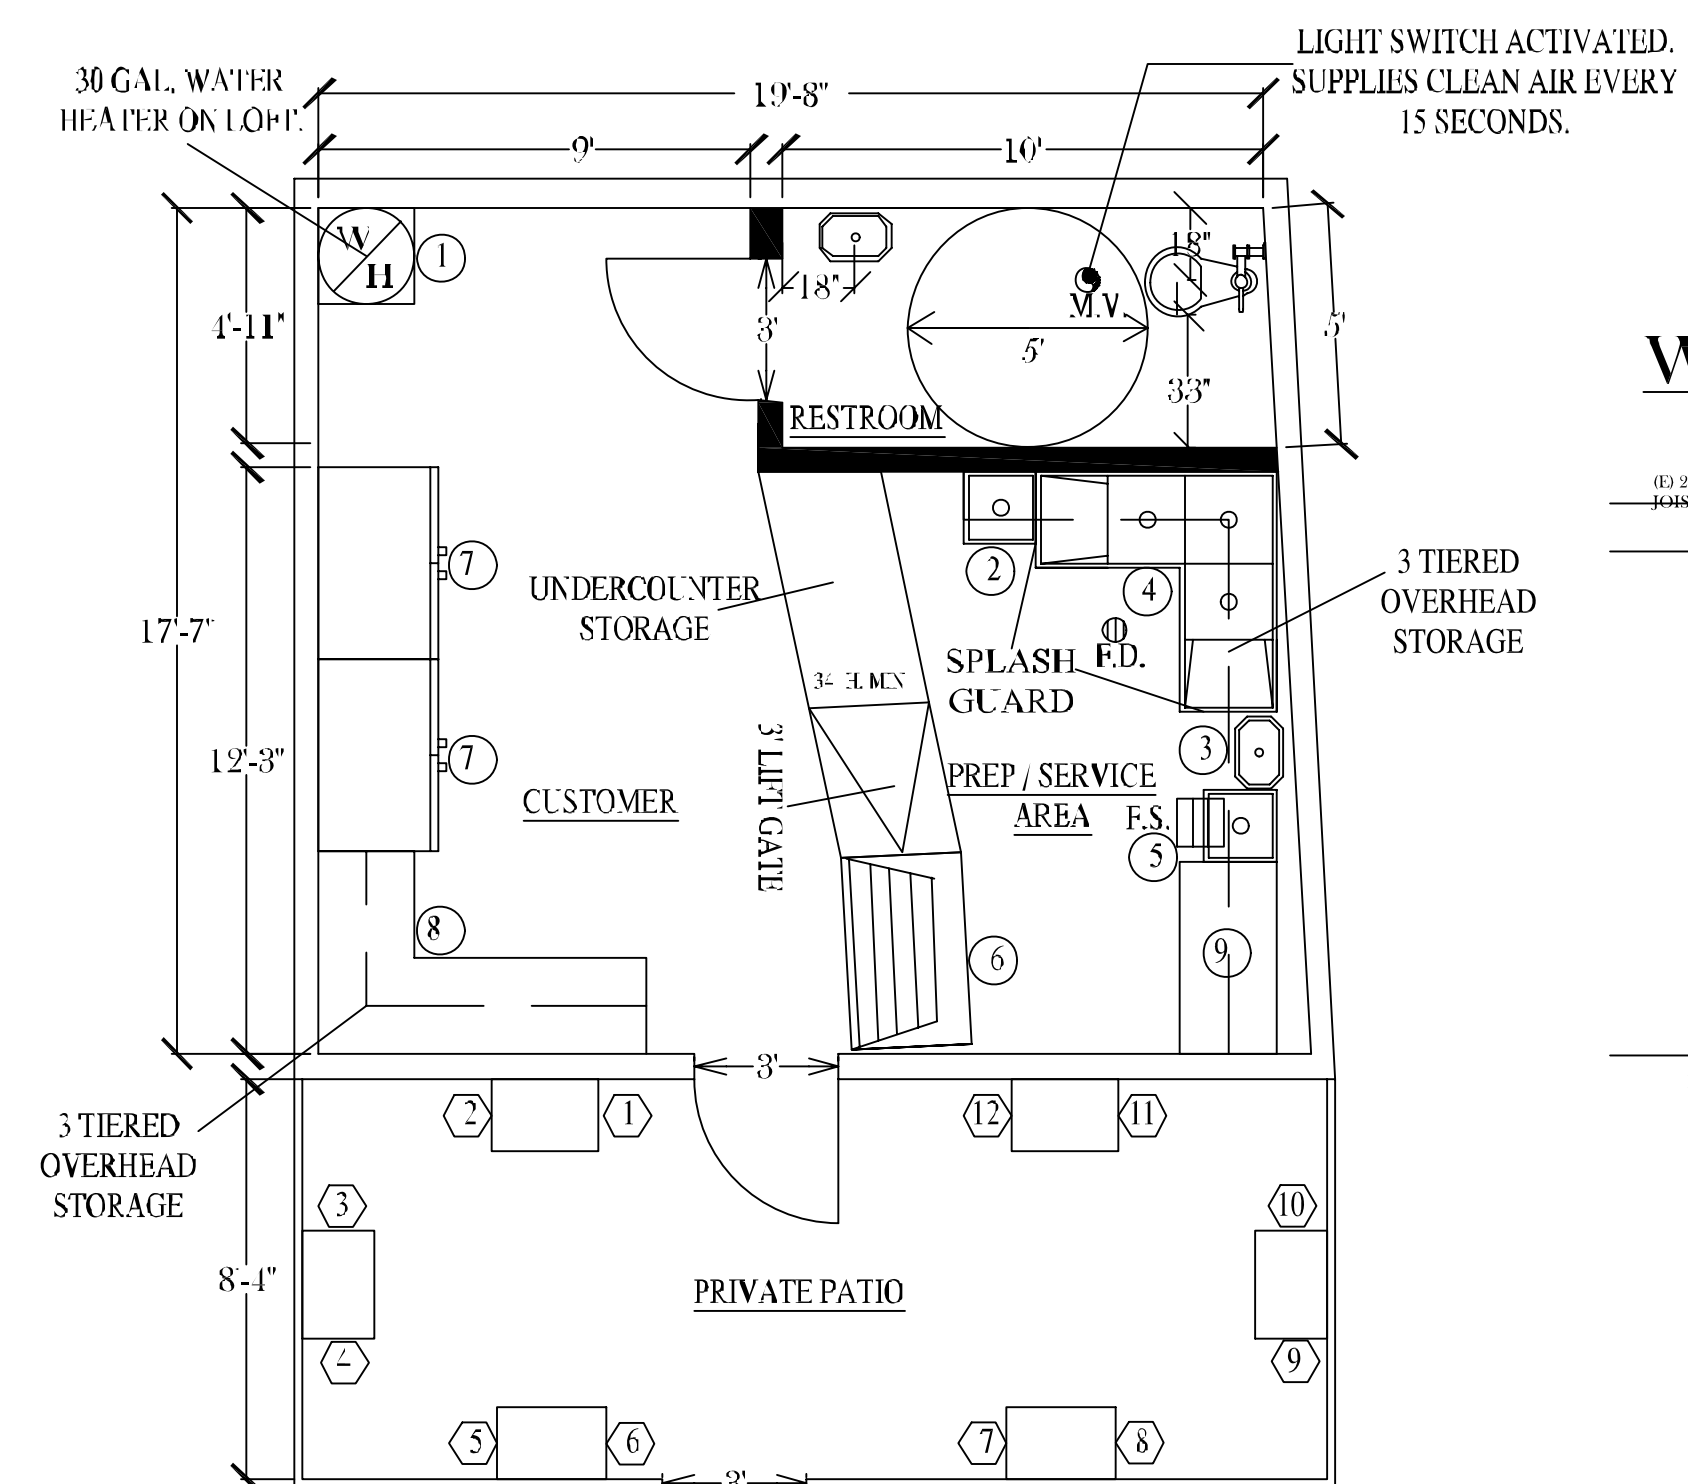

FLOOR PLAN

353 SQ. FT.
EXISTING DELI / MARKET.
RE-MODELING TO UP-GRADE
RESTROOMS AND REQUIRED SINKS.

WALL DETAIL

